

- 1. THE SUBJECT PROPERTY IS THE LANDS OF JMS, LLC AS RECORDED IN OFFICIAL RECORDS BOOK 18201 PAGE 657, AMONG THE LANDS RECORDS OF HILLSBOROUGH COUNTY, FLORIDA AND HAVING A PIN OF A-09-30-18-ZZZ-000005-53450.1 PER THE HILLSBOROUGH PROPERTY APPRAISER. THE PROPERTY IS LYING IN SECTION 9; TOWNSHIP 30 SOUTH; RANGE 18 EAST.
- 2. AREA = 77,274 SQUARE FEET OR 1.774 ACRES. (MEASURED)
- 3. LOCATION OF ALL UNDERGROUND UTILITIES ARE APPROXIMATE, SOURCE INFORMATION FROM PLANS AND MARKINGS HAS BEEN COMBINED WITH OBSERVED EVIDENCE OF UTILITIES TO DEVELOP A VIEW OF THOSE UNDERGROUND UTILITIES. HOWEVER, LACKING EXCAVATION, THE EXACT LOCATION OF UNDERGROUND FEATURES CANNOT BE ACCURATELY. COMPLETELY AND RELIABLY DEPICTED. WHERE ADDITIONAL OR MORE DETAILED INFORMATION IS REQUIRED, THE CLIENT IS ADVISED THAT EXCAVATION MAY BE NECESSARY.
- 4. THIS SURVEY WAS PERFORMED IN THE FIELD ON MARCH 3, 2023 UTILIZING THE REFERENCE DOCUMENTS AS LISTED HEREON AND DEPICTS BUILDINGS, STRUCTURES AND OTHER IMPROVEMENTS. REVISIONS LISTED ON THIS SURVEY APPLY ONLY TO THE SPECIFIC CHANGES REFERENCED. AND DO NOT CONSTITUTE AN UPDATE OF OTHER DATA ON THIS SURVEY. THE "SURVEY DATE" SHOWN HEREON IS THE APPLICABLE DATE AS RELATED TO PROVISIONS OF STATUTES OF LIMITATION UNLESS NOTED OTHERWISE.
- 5. ELEVATIONS ARE BASED ON NAVD88 DATUM DETERMINED BY GPS OBSERVATIONS AND TIED IN TO THE NGS NO. AG7564 WITH A PUBLISHED ELEVATION OF 2.64 FEET.
- 6. THE PROPERTY IS LOCATED IN SPECIAL FLOOD AREAS ZONE AE (WITH BASE FLOOD ELEVATION OF 10 FEET) PER MAP ENTITLED "FIRM, FLOOD INSURANCE RATE MAP, HILLSBOROUGH COUNTY, FLORIDA AND INCORPORATED AREAS, PANEL 344 OF 801", MAP NUMBER 12057C0344J, WITH A MAP REVISION DATE OF
- 7. ZONING: NO ZONING REPORT OR ZONING LETTER WAS PROVIDED TO THE SURVEYOR.
- 8. NO SURVEY OF SUBTERRANEAN STRUCTURES OR INTERIOR SPACES SUCH AS FOOTINGS, FOUNDATIONS, VAULTS OR BASEMENTS WAS PERFORMED AS PART OF THIS LAND SURVEY, AND THIS PLAN SHOULD NOT BE CONSTRUED AS CERTIFICATION TO THE EXISTENCE OR LOCATION OF THE SAME.
- 9. TREES 5" INCHES DIAMETER AT BREAST HEIGHT (DBH) AND LARGER HAVE BEEN LOCATED WITHIN THE PROJECT
- 10. PARKING: NO IDENTIFIABLE PARKING STRIPING WAS FOUND AT TIME OF SURVEY.
- 11. THERE ARE NO VISIBLE ENCROACHMENTS EXCEPT AS SHOWN ON THE SURVEY ENCROACHMENT IS A LEGAL CONDITION, NOT A MATTER OF SURVEY AND, AS A RESULT, THERE MAY BE OTHER POSSIBLE ENCROACHMENTS AFFECTING THE PROPERTY THAT ARE NOT SHOWN.
- 12. THE PROPERTY HAS ACCESS ALONG S. LOIS AVENUE.
- 13. THIS SURVEY WAS PREPARED IN ACCORDANCE WITH THE "STANDARDS OF PRACTICE", AS SET FORTH BY THE FLORIDA BOARD OF PROFESSIONAL SURVEYORS AND MAPPERS IN RULES 5J-17.050 THROUGH 5J-17.053, OF THE FLORIDA ADMINISTRATIVE CODE.
- 14. THE DATUM FOR THIS SITE WAS ESTABLISHED UTILIZING GLOBAL POSITION SYSTEMS, AND BASED ON POSITIONAL VALUES FOR THE VIRTUAL REFERENCE STATION NETWORK DEVELOPED BY TRIMBLE.
- 15. BASIS OF BEARINGS: THE BEARINGS SHOWN HEREON ARE RELATIVE TO THE FLORIDA STATE PLANE COORDINATE SYSTEM, WEST ZONE, NORTH AMERICAN DATUM OF 1983 - 2011 ADJUSTMENT, HOLDING THE WEST LINE OF THE SUBJECT PROPERTY ALSO BEING THE EAST LINE OF TRACT "B" OF LOIS AVENUE - GANDY BOULEVARD PLAT BEING NORTH 00°24'36" EAST.
- 16. THE LEGAL DESCRIPTION IS RECORDED IN OFFICIAL RECORD BOOK 18201 PAGE 657.
- 17. ALL DISTANCES ARE MEASURED GROUND DISTANCES UNLESS NOTED OTHERWISE.
- 18. THE USE OF THE PROPERTY IS CURRENTLY A STORAGE FACILITY.
- 19. THE CONTRACTED PURPOSE OF THIS SURVEY IS FOR PERMITTING, SITE PLAN, OR TRANSACTION, THIS SURVEY
- 20. ADDITIONS OR DELETIONS TO SURVEY MAPS OR REPORTS BY ANYONE OTHER THAN THE SIGNING PARTY OR PARTIES IS PROHIBITED WITHOUT WRITTEN CONSENT OF THE SIGNING PARTY OR PARTIES.
- 21. THIS SURVEY WAS PREPARED FOR THE PARTIES LISTED BELOW AND IS NOT ASSIGNABLE:
- 22. THIS MAP IN INTENDED TO BE DEPICTED AT A SCALE OF 1"=20' ON 24"X36" SHEETS. UNITS SHOWN ARE U.S.
- 23. SOME TOPOGRAPHIC FEATURES MAY BE EXAGGERATED IN SCALE FOR CLARITY. THE CENTER OF THE SYMBOL OF SUCH FEATURES IS THE CORRECT LOCATIONS.
- 24. RIGHT-OF-WAY LINES SHOWN ON THIS SURVEY THAT ARE NOT ACTUAL BOUNDARIES OF THE SUBJECT TRACT(S) ARE DEPICTED GRAPHICALLY AND ARE SHOWN APPROXIMATELY FOR INFORMATIONAL PURPOSES
- 25. © COPYRIGHT 2023 BY BOHLER ENGINEERING FL, LLC. REPRODUCTIONS OF THIS SURVEY ARE NOT VALID WITHOUT THE ORIGINAL SIGNATURE AND STAMP, OR A DIGITALLY VERIFIED ELECTRONIC SIGNATURE AND SEAL, OF A FLORIDA LICENSED SURVEYOR AND MAPPER

## TITLE NOTES:

THIS SURVEY IS PREPARED WITH REFERENCE TO A COMMITMENT FOR TITLE INSURANCE PREPARED BY OLD REPUBLIC NATIONAL TITLE INSURANCE COMPANY, COMMITMENT NO. 23016797 MA, WITH A COMMITMENT DATE OF FEBRUARY 13, 2023. OUR OFFICE HAS REVIEWED THE FOLLOWING SURVEY RELATED EXCEPTIONS IN SCHEDULE B,

(7.) GRANT OF EASEMENT TO TAMPA ELECTRIC COMPANY, RECORDED IN O.R. BOOK 20396, PAGE 170, OF THE PUBLIC RECORDS OF HILLSBOROUGH COUNTY, FLORIDA; MAY AFFECT THE SUBJECT PROPERTY. HOWEVER, OVERHEAD WIRES WERE LOCATED ON THE SUBJECT PROPERTY AND ARE SHOWN ON THE SURVEY.

## **LEGAL DESCRIPTION:**

THE NORTH 543.56 FEET OF THE SOUTH 1168.56 FEET OF THE WEST 300.50 FEET OF THE EAST 325.50 FEET OF THE NORTH 2/3 OF THE WEST 1/2 OF THE NORTHWEST 1/4 OF SECTION 9, TOWNSHIP 30 SOUTH, RANGE 18 EAST, HILLSBOROUGH COUNTY, FLORIDA; LESS A EXCEPTION IN THE NORTHEAST CORNER THEREOF, ALL BEING OTHERWISE DESCRIBED AS:

COMMENCING AT THE SOUTHEAST CORNER OF TRACT "B" OF LOIS AVENUE - GANDY BOULEVARD, AS RECORDED IN PLAT BOOK 30, PAGE 85, OF THE PUBLIC RECORDS OF HILLSBOROUGH COUNTY, FLORIDA; RUN THENCE NORTH ALONG THE EAST BOUNDARY OF SAID TRACT "B", FOR 625.00 FEET TO THE POINT OF BEGINNING OF THE TRACT HEREIN DESCRIBED; RUN THENCE EAST PARALLEL TO THE SOUTH BOUNDARY OF THE NORTH 2/3 OF THE WEST 1/2 OF THE NORTHWEST 1/4 OF SECTION 9, TOWNSHIP 30 SOUTH, RANGE 18 EAST, HILLSBOROUGH COUNTY, FLORIDA, FOR 300.50 FEET TO THE WEST BOUNDARY OF TRACT "C" OF SAID PLAT; THENCE NORTH ALONG THE WEST BOUNDARY OF SAID TRACT "C" FOR 451.40 FEET: THENCE NORTH 07° 09 MIN WEST. FOR 67.89 FEET: THENCE ALONG THE ARC OF A CURVE TO THE RIGHT WHOSE RADIUS IS 391.56 FEET A DISTANCE OF 24.94 FEET TO A POINT THAT IS 10.77 FEET WEST OF THE WEST BOUNDARY OF SAID TRACT "C"; THENCE WEST PARALLEL TO SAID SOUTH BOUNDARY OF THE NORTH 2/3 OF THE WEST 1/2 OF THE NORTHWEST 1/4, FOR 289.73 FEET TO THE EAST BOUNDARY OF SAID TRACT "B"; THENCE SOUTH ALONG THE EAST BOUNDARY OF SAID TRACT "B", FOR 543.56 FEET TO THE POINT OF

LESS AND EXCEPT THE FOLLOWING CONVEYED BY DEED RECORDED IN OFFICIAL RECORDS INSTRUMENT NO. 2021658014, DESCRIBED AS FOLLOWS:


THAT PART OF THE NORTHWEST 1/4 OF SECTION 9, TOWNSHIP 30 SOUTH, RANGE 18 EAST, HILLSBOROUGH COUNTY,

COMMENCE AT THE SOUTHEAST CORNER OF TRACT "B", LOIS AVENUE-GANDY BOULEVARD, ACCORDING TO THE PLAT THEREOF, AS RECORDED IN PLAT BOOK 30, PAGE 85, OF THE PUBLIC RECORDS OF HILLSBOROUGH COUNTY,

THENCE N. 00° 24' 36" E., ALONG THE EAST BOUNDARY OF SAID TRACT "B", A DISTANCE OF 881.85 FEET TO THE POINT OF BEGINNING; THENCE CONTINUE N. 00° 24' 36" E., ALONG SAID EAST BOUNDARY. A DISTANCE OF 286.71 FEET; THENCE S. 89° 23' 27" E., A DISTANCE OF 289.73 FEET; THENCE 24.94 FEET ALONG THE ARC OF A NON-TANGENT CURVE TO THE LEFT, HAVING A RADIUS OF 391.56 FEET AND A CENTRAL ANGLE OF 03° 38' 58" (CHORD BEARING S. 04° 55' 07" E., A DISTANCE OF 24.94 FEET); THENCE S. 06° 44' 36" E., A DISTANCE OF 67.89 FEET TO THE WEST BOUNDARY OF TRACT "C" OF SAID LOIS AVENUE-GANDY BOULEVARD; THENCE S. 00° 24' 36" W., ALONG SAID WEST BOUNDARY, A DISTANCE OF 193.48 FEET; THENCE N. 89° 35' 46" W., A DISTANCE OF 300.50 FEET TO THE POINT OF BEGINNING.

TO: SIGHT DEVELOPMENT LLC; JMS, LLC, A FLORIDA LIMITED LIABILITY COMPANY: & OLD REPUBLIC NATIONAL TITLE INSURANCE COMPANY.

THIS IS TO CERTIFY THAT THIS MAP OR PLAT AND THE SURVEY ON WHICH IT IS BASED WERE MADE IN ACCORDANCE WITH THE 2021 MINIMUM STANDARD DETAIL REQUIREMENTS FOR ALTA/NSPS LAND TITLE SURVEYS, JOINTLY ESTABLISHED AND ADOPTED BY ALTA AND NSPS, AND INCLUDES ITEMS 1, 2, 3, 4, 5, 7(A), 7(B)(1), 8, 9, 11(A), 13, & 14 OF TABLE A THEREOF. THE FIELD WORK WAS COMPLETED ON MARCH 3, 2023.

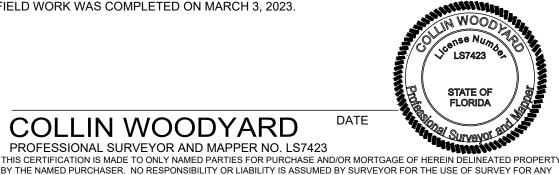

**ALTA/NSPS LAND TITLE SURVEY** 

SIGHT DEVELOPMENT, LLC



## Ronnie Place W Wisconsin Ave w Wisconsin Ave Ohio Ave

Arlene Maror

Guernsey Estates

92 W Gandy Blvd

## LOCATION MAP

Bay Breeze Treasure Park

SCALE: 1"=2000'

**LEGEND** EXISTING CONTOUR EXISTING SPOT ELEVATION

X 123.45 EXIST. TOP OF CURB ELEVATION EXIST. GUTTER ELEVATION

HYDRANT WATER VALVE OVERHEAD WIRES

UTILITY POLE SANITARY MANHOLE

STORM DRAIN MANHOLE

MAIL BOX FENCE

FIRE DEPARTMENT CONNECTION

PAINTED ARROWS BENCHMARK

TREE (SIZE AS NOTED)

PALM TREE (SIZE AS NOTED) PINE TREE (SIZE AS NOTED)

MEASURED

CAPPED IRON REBAR FOUND IRON REBAR FOUND

IRON PIPE FOUND PLAT BOOK OFFICIAL RECORD BOOK

**TYPICAL** NORTH SOUTH EAST

CONCRETE CENTERLINE PROPERTY LINE

PLUS OR MINUS REINFORCED CONCRETE PIPE RCP ADAAMERICANS WITH DISABILITIES ACT MANHOLE ELEV. **ELEVATION** 

SQUARE FOOT ACRE NOW OR FORMERLY RIGHT-OF-WAY



UTILITIES:

P.B.

(TYP.)

Call before you dig. **Dial 811** Or Call 800-432-4770

(813) 898-1406

(813) 231-5291

(800) 778-9140

(813) 275-3059

(813) 422-2805

(800) 961-6500

G.S. 4/10/2023

BY: DATE

PHONE HUMBER

Know what's **below**.

THE FOLLOWING COMPANIES WERE NOTIFIED BY SUNSHINE 811 UTILITY SYSTEM (1-800-432-4770) AND REQUESTED TO MARK OUT UNDERGROUND FACILITIES AFFECTING AND SERVICING THIS SITE. THE UNDERGROUND UTILITY INFORMATION SHOWN HEREON IS BASED UPON THE UTILITY COMPANIES RESPONSE TO THIS REQUEST. SERIAL NUMBER(S): 062305360

LOCATE STATUS UTILITY COMPANY CITY OF TAMPA SEWER NO RESPONSE NO CONFLICT CITY OF TAMPA WATER NO RESPONSE FRONTIER COMMUNICATIONS SPECTRUM SUNSHINE STATE, LLC NO RESPONSE TAMPA ELECTRIC COMPANY CLEAR NO FACILITIES TECO PEOPLES GAS - TAMPA NO RESPONSE

NO RESPONSE ZAYO GROUP

ADDRESSED ATTORNEY COMMENTS DESCRIPTION OF REVISION

5000 S. LOIS AVENUE CITY OF TAMPA, FLORIDA HILLSBOROUGH COUNTY